




- STUDY BOUNDARY
- . - MATCH LINE
- PEDESTRIAN CIRCULATION
- VEHICULAR CIRCULATION
- RETAINING WALL
- BUILDING
- FENCE

- TREE
- PALM TREE
- CONTOUR LINE


LAYOUT PLAN QUADRANT 4S

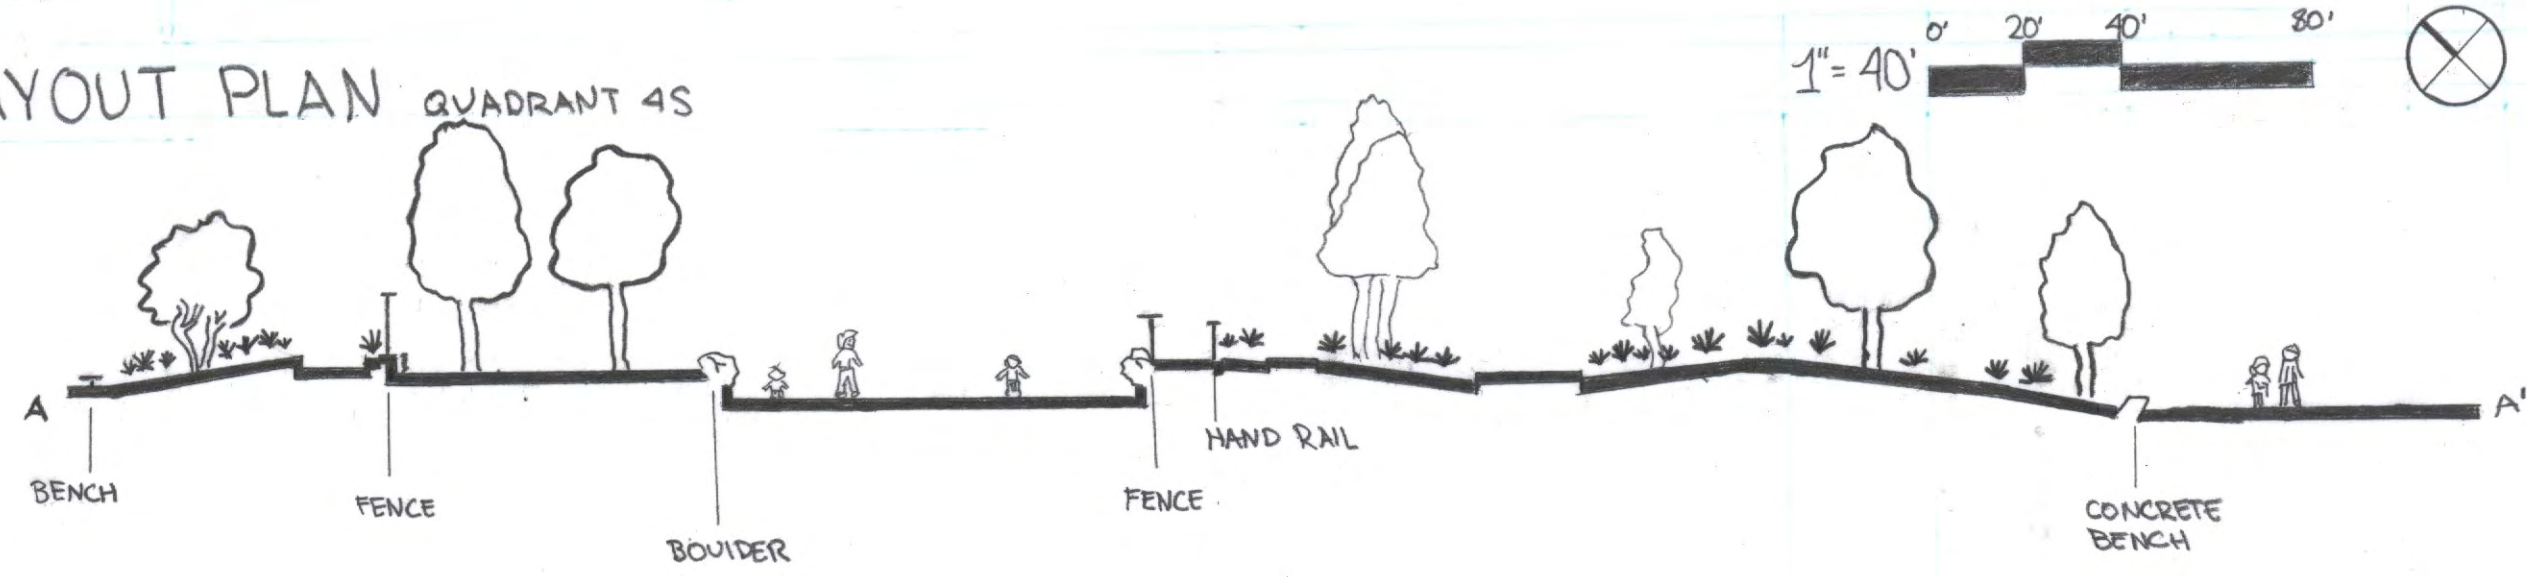

SECTION/ELEVATION QUADRANT 4S A-A'

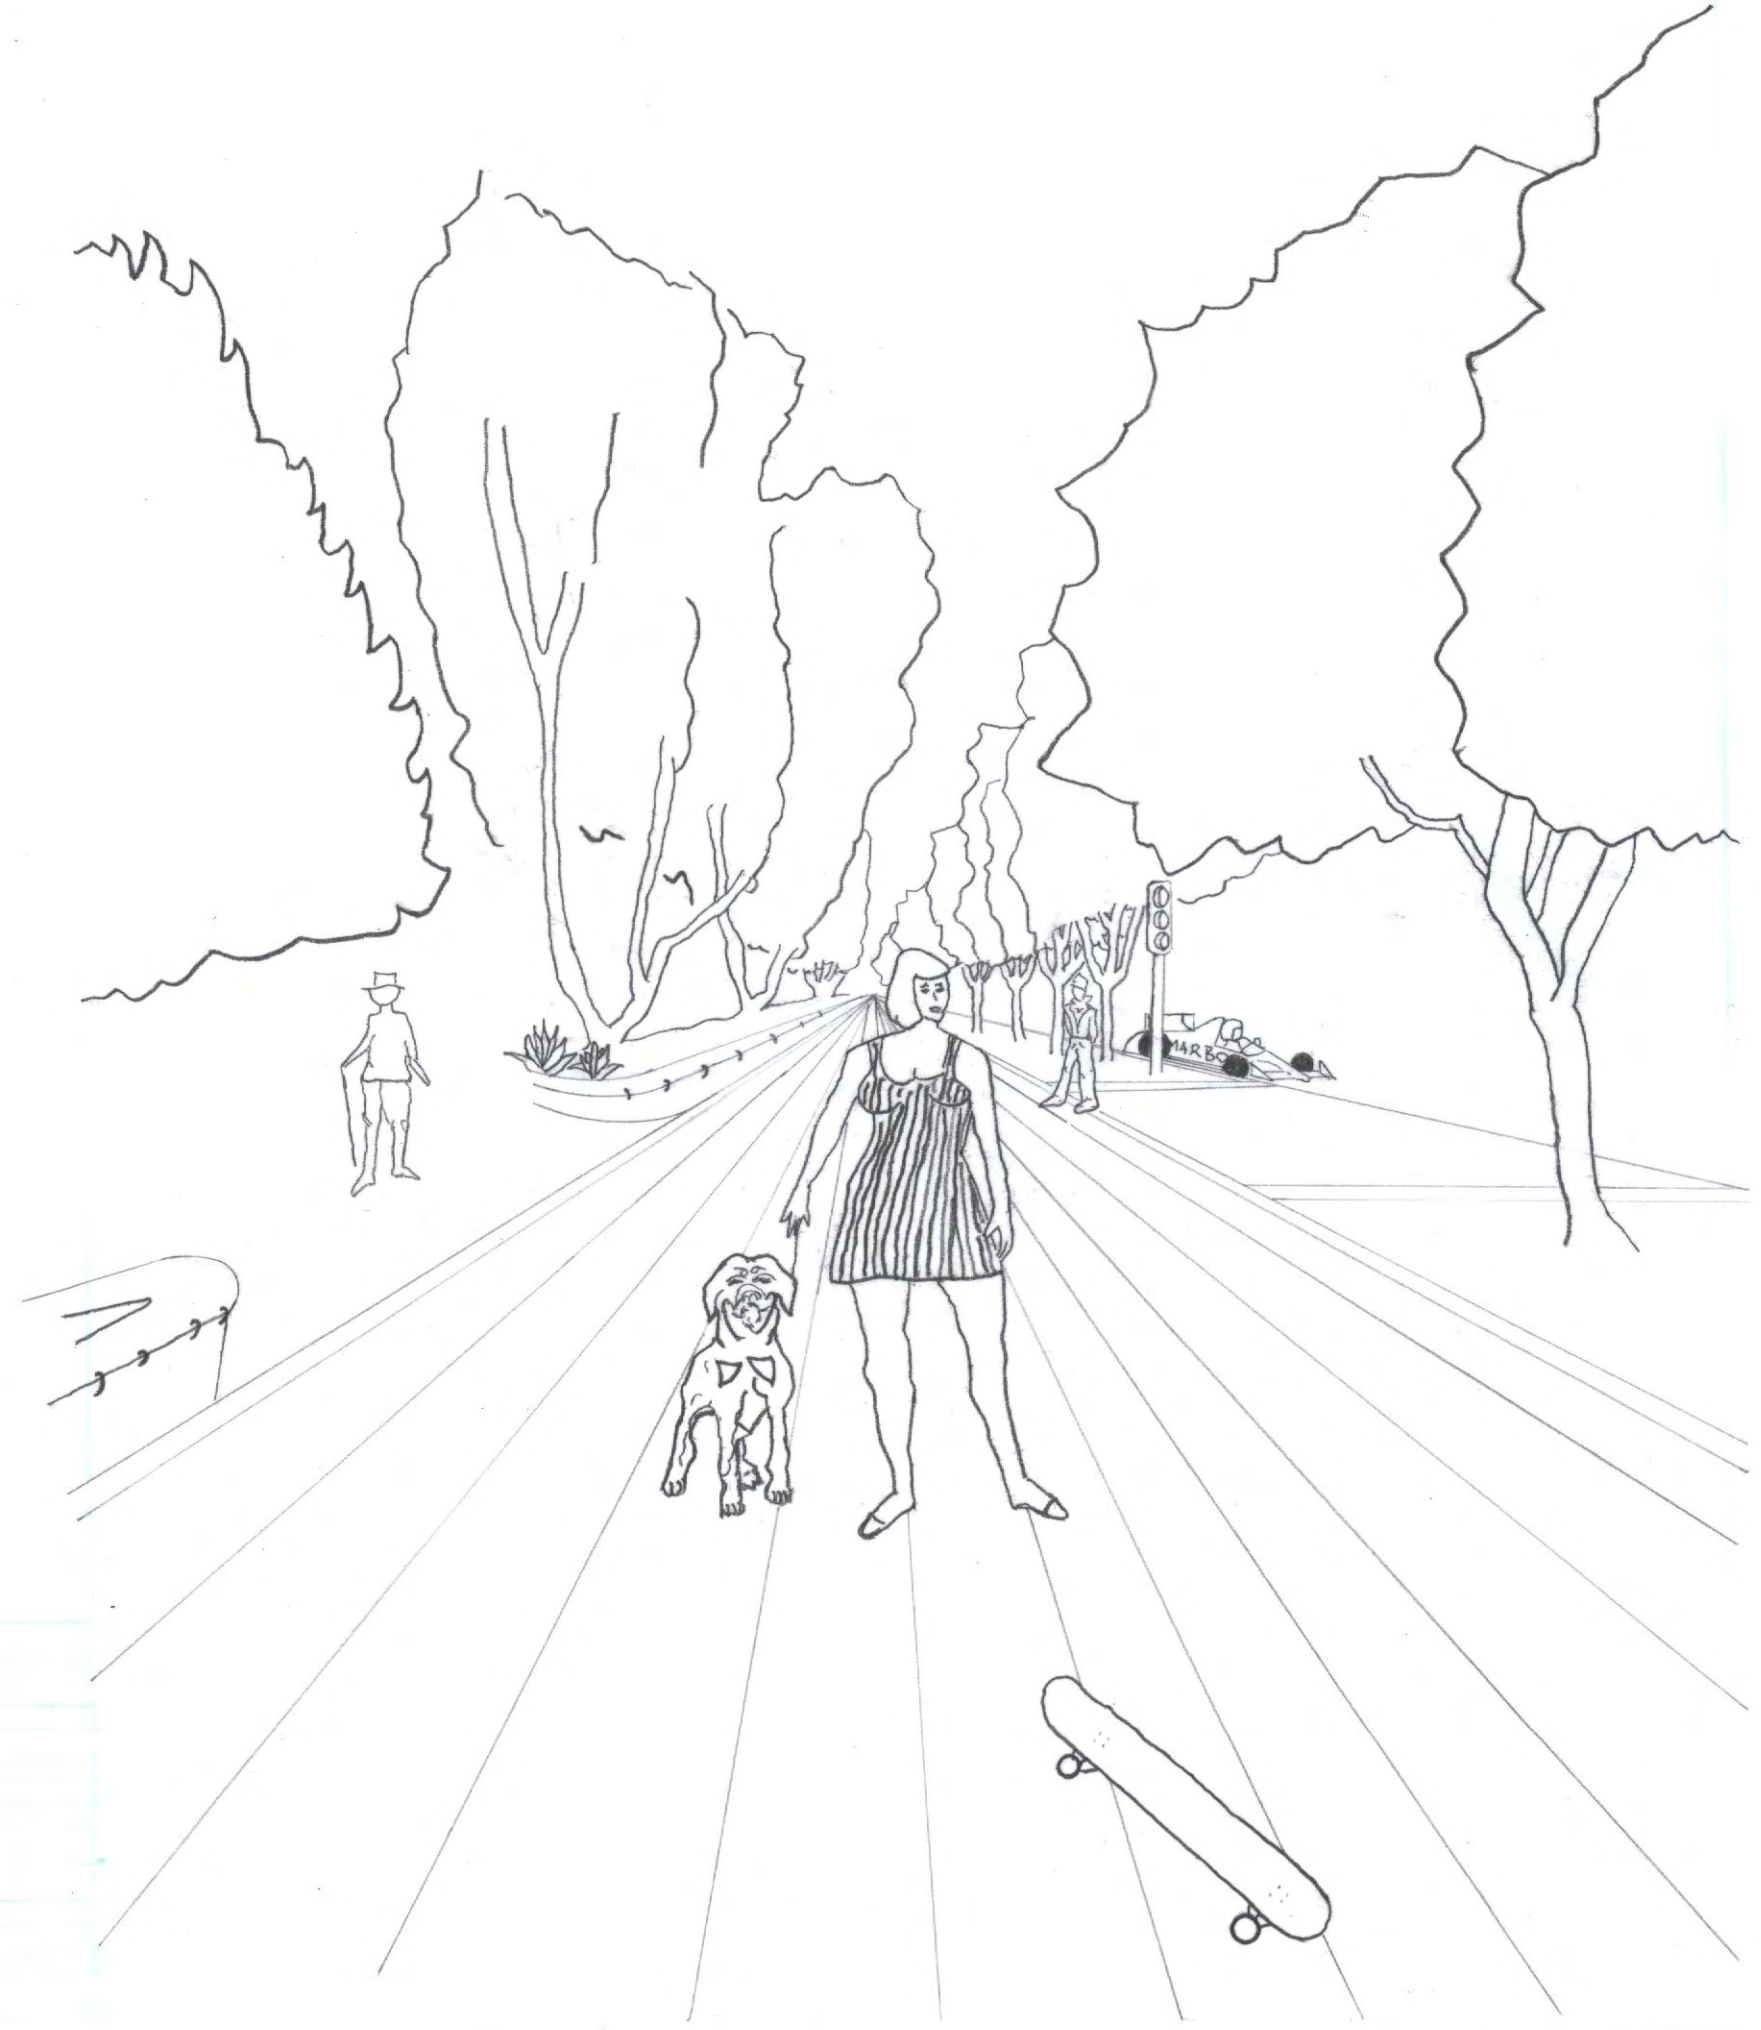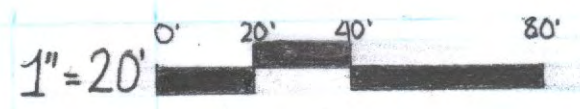

PERSPECTIVE DRAWING

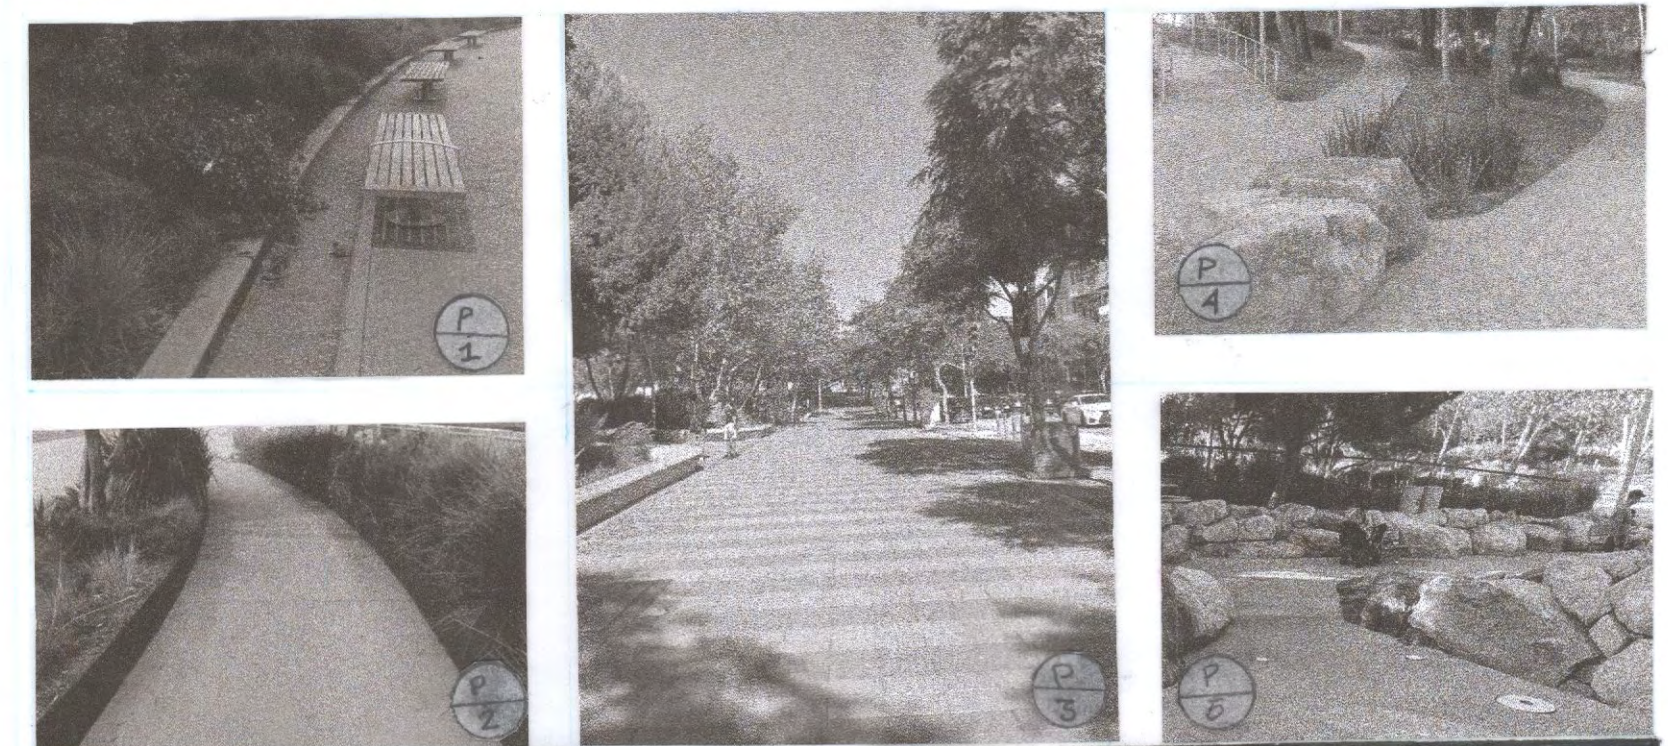

12/10/2022 DATE	TONGVA PARK DESIGN GRAPHICS I - DAVID SQUIRES DRAWN BY ROGER VASQUEZ	SEE SCALE BAR SCALE 1 / 1 SHEET
APPROVAL / SCORE		